

**SCHEDULE 1+2+3 (MADISON COUNTY) ASSESSMENT AREA**  
 ~ \$548 (~~\$681~~) PER PARCEL, PER YEAR  
 (\$432 (~~\$565~~) Bond and \$116 - Maintenance Schs. 2 & 3)


**SCHEDULE 1+2+3 (GALLATIN COUNTY) ASSESSMENT AREA**  
 ~ \$ 558 (~~\$712~~) PER PARCEL, PER YEAR  
 (\$442 (~~\$586~~) -Bond and \$116 -Maintenance Schs. 2 & 3)

**SCHEDULE 2&3 ONLY- NO MAINTENANCE ASSESSMENT (GALLATIN COUNTY) ASSESSMENT AREA**  
 ~ \$390 (~~\$513~~) PER PARCEL, PER YEAR  
 (\$390 (~~\$513~~) -Bond and \$0 -No Maintenance)

**SCHEDULE 1 ONLY (GALLATIN COUNTY) ASSESSMENT AREA**  
 ~ \$52 (~~\$83~~) PER PARCEL, PER YR.  
 (\$52 (~~\$83~~) Bond and \$0 -No Maintenance)

**SCHEDULE 1 + SCHD 2 MAINTENANCE (GALLATIN CO.) ASSESSMENT AREA**  
 ~ \$ 83 (~~\$144~~) PER PARCEL, PER YEAR  
 (\$52 (~~\$83~~) -Bond and \$31-Maintenance Sch. 2)

**SCHEDULE 1+2 (GALLATIN COUNTY) ASSESSMENT AREA**  
 ~ \$ 128 (~~\$161~~) PER PARCEL, PER YR.  
 (\$97 (~~\$128~~) -Bond & \$31-Maintenance Sch. 2)

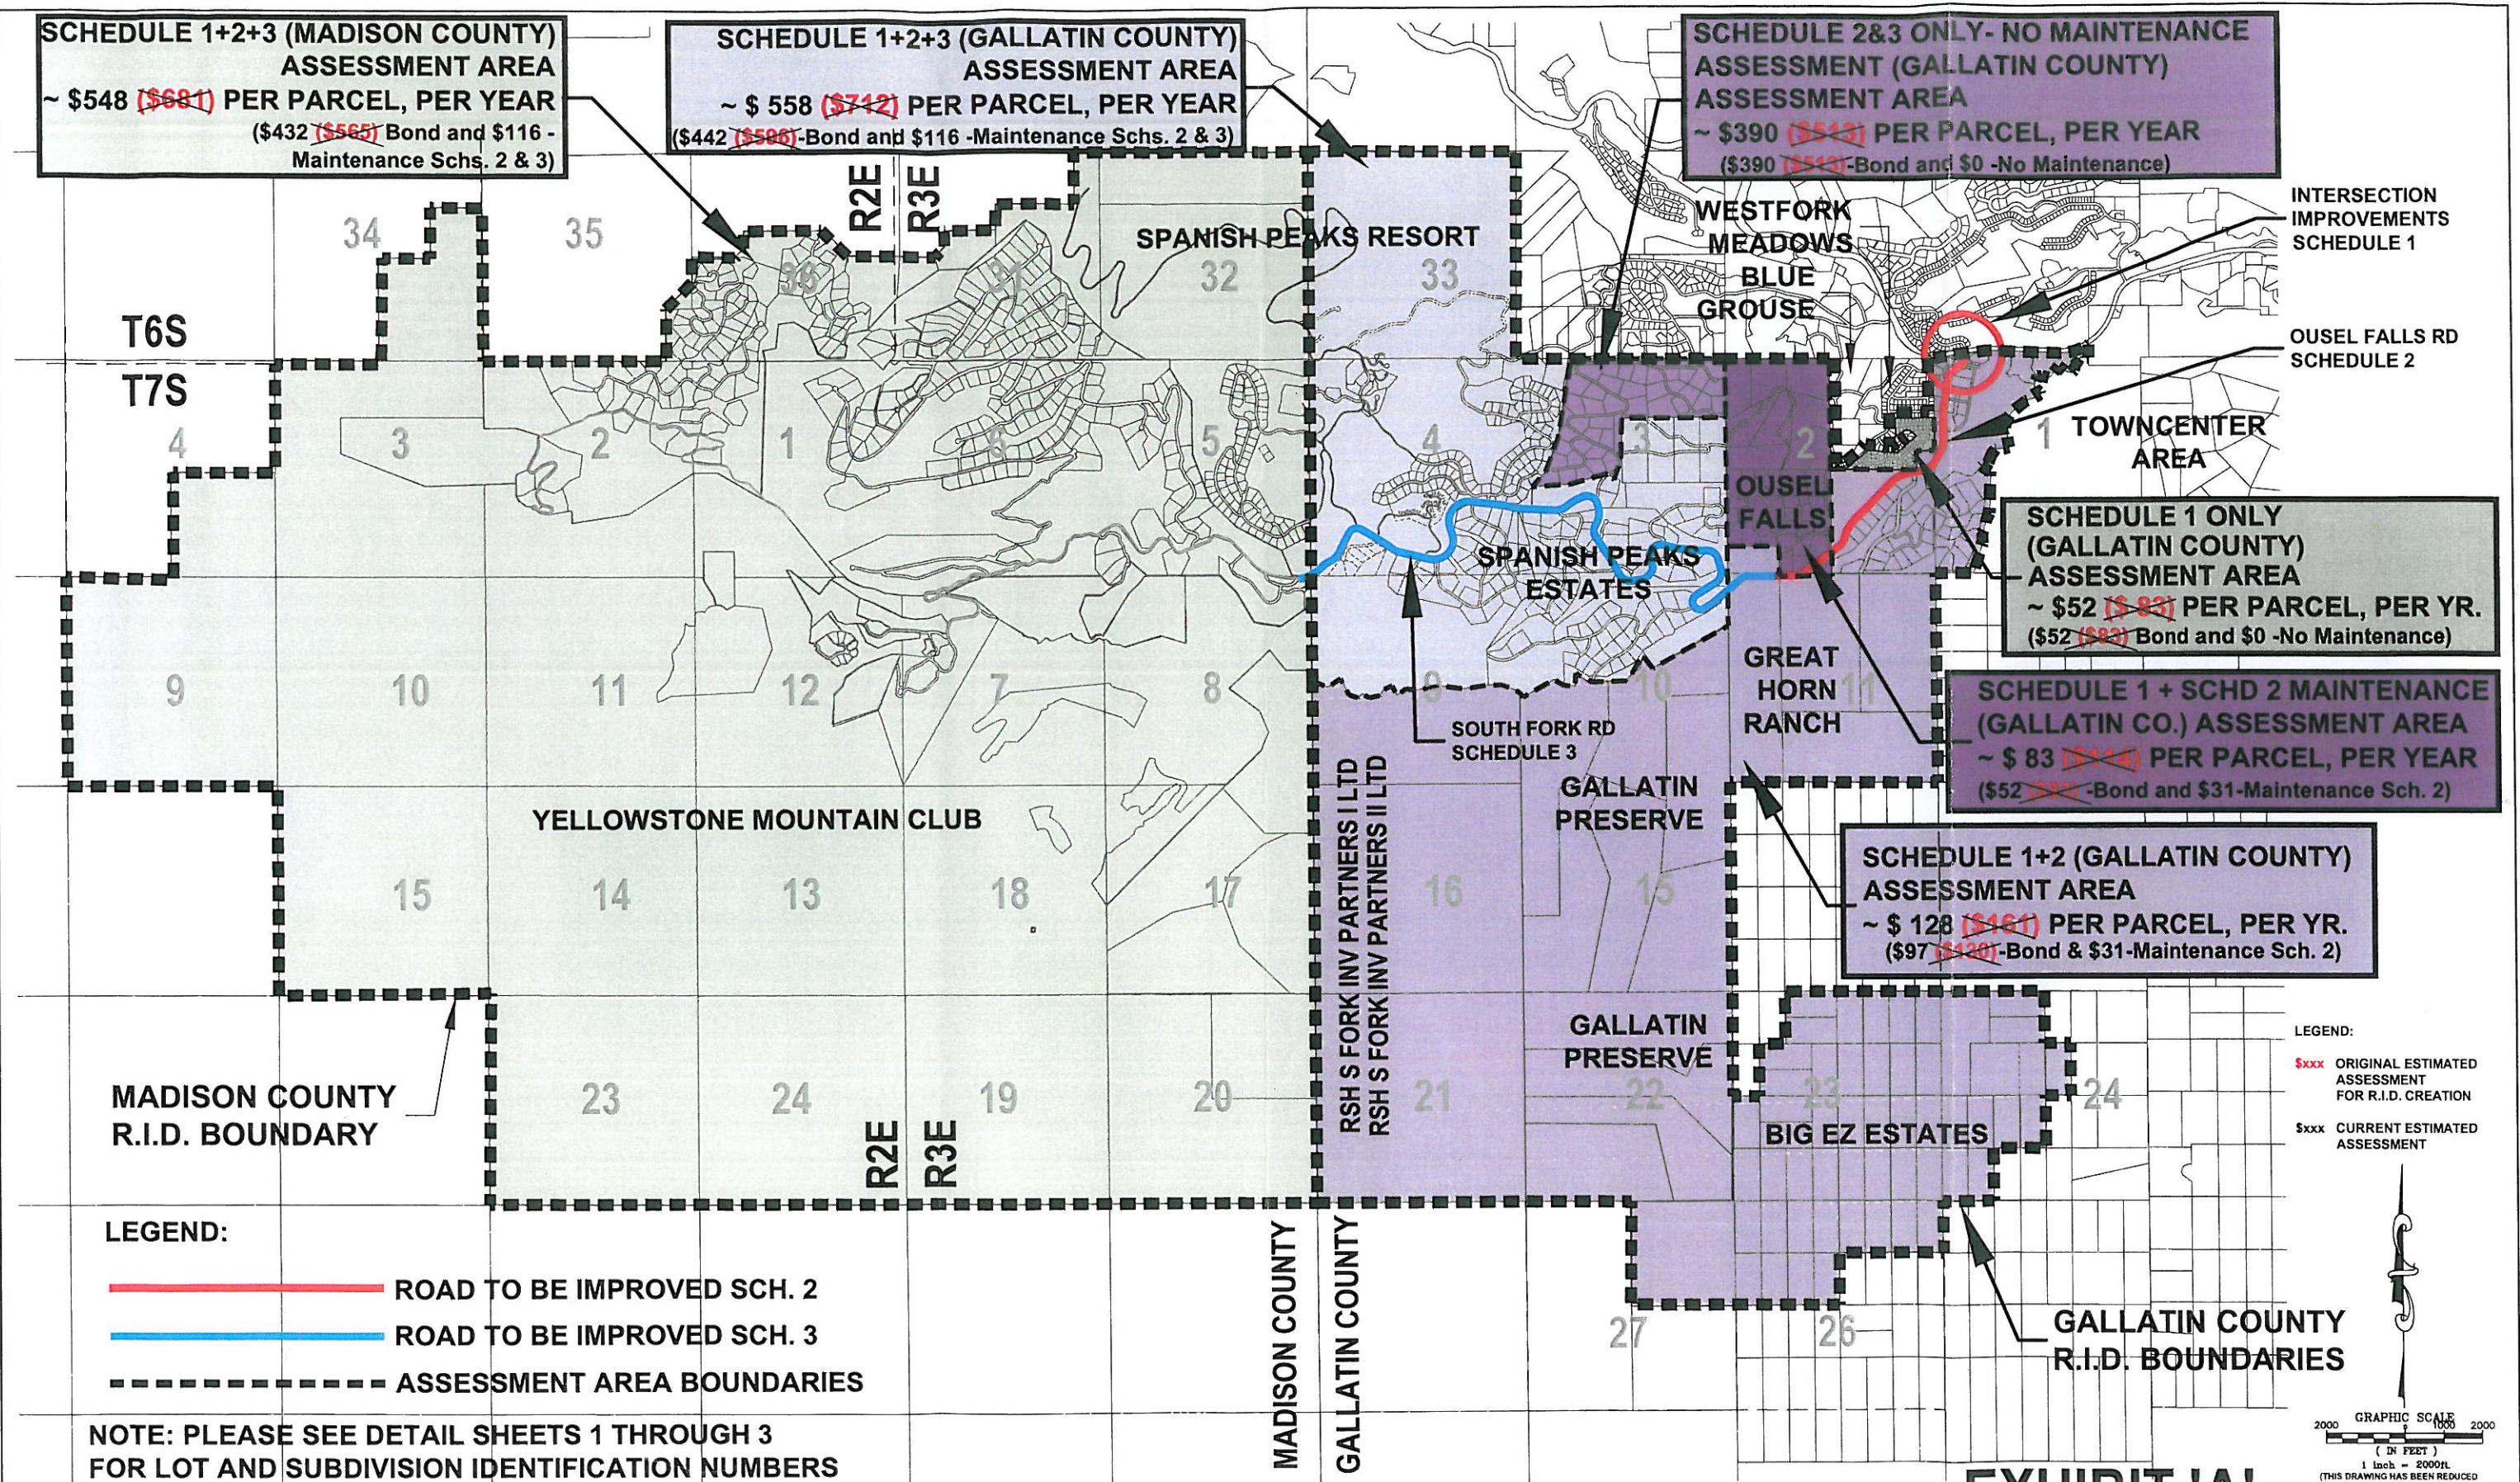

INTERSECTION IMPROVEMENTS SCHEDULE 1

OUSEL FALLS RD SCHEDULE 2

TOWNCENTER AREA


SOUTH FORK RD SCHEDULE 3

**LEGEND:**

- ROAD TO BE IMPROVED SCH. 2
- ROAD TO BE IMPROVED SCH. 3
- ASSESSMENT AREA BOUNDARIES

**NOTE: PLEASE SEE DETAIL SHEETS 1 THROUGH 3 FOR LOT AND SUBDIVISION IDENTIFICATION NUMBERS**

**LEGEND:**  
 \$xxx ORIGINAL ESTIMATED ASSESSMENT FOR R.I.D. CREATION  
 \$xxx CURRENT ESTIMATED ASSESSMENT

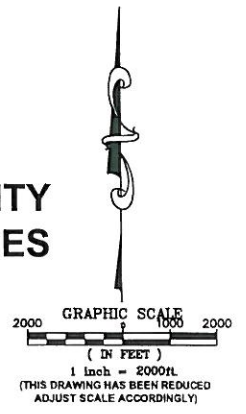

**EXHIBIT 'A'**

VERIFY SCALE!		REVISIONS		
NO.	DESCRIPTION	DATE	BY	
1	ADJUSTED SCHEDULE BOUNDARIES IN OUSEL FALLS AREA-KSS	4-20-09	KSS	
2	FINAL EXHIBIT	5-1-09	KSS	
3	UPDATED ASSESSMENT VALUES	7-8-2010	KSS	

**MORRISON MAIERLE, INC.**  
*An Employee-Owned Company*

2880 Technology Blvd. W.  
 Bozeman, MT 59718  
 Phone: (406) 587-0721  
 Fax: (406) 922-6702

DRAWN BY: KSS  
 CHK'D BY: CB  
 APPR. BY: JS  
 DATE: 4-02-09  
 Q.A. REVIEW BY:  
 DATE:

**BIG SKY**  
 OUSEL FALLS & SOUTH FORK ROAD & INTERSECTION IMPROVEMENTS  
 GALLATIN AND MADISON COUNTY RID  
 MT  
**PARCEL ASSESSMENT MAP-UPDATE**

PROJECT NUMBER N:10928.171.010.0310
SHEET NUMBER 1
DRAWING NUMBER 1-4

N:\0928171\ACAD\Exhibits\EXHIBIT 'A'-UPDATE.dwg Plotted by karen schunke on Jul/8/2010

COPYRIGHT © MORRISON MAIERLE, INC., 2010